

**● PRINTER RUSH ●**  
**(PTO ASSISTANCE)**

Application :	<u>10/677768</u>		Examiner :	<u>Perry, A</u>		GAU :	<u>2879</u>	
From:	<u>flgc</u>		Location:	<u>IDC</u>	<u>FMF</u>	<u>FDC</u>	Date:	<u>04-10-05</u>
			Tracking #:	<u>06108204</u>			Week Date:	<u>05-23-05</u>

DOC CODE	DOC DATE	MISCELLANEOUS
<input type="checkbox"/> 1449		<input type="checkbox"/> Continuing Data
<input type="checkbox"/> IDS		<input type="checkbox"/> Foreign Priority
<input type="checkbox"/> CLM		<input type="checkbox"/> Document Legibility
<input type="checkbox"/> IIFW		<input type="checkbox"/> Fees
<input type="checkbox"/> SREW		<input type="checkbox"/> Other
<input checked="" type="checkbox"/> DRW	<u>10-02-2003</u>	
<input type="checkbox"/> OATH		
<input type="checkbox"/> 312		
<input type="checkbox"/> SPEC		

ATTENTION : Chief Draftsperson

[RUSH] MESSAGE: DRAWINGS: Figure 8 of drawings dated 10/2/03

contains red line corrections. Please resolve.

*thank you*

*flgc*

[XRUSH] RESPONSE: Examiner has included corrected sheet #3 of 3 w/o  
red line corrections.

INITIALS: *ATP*

NOTE: This form will be included as part of the official USPTO record, with the Response  
document coded as XRUSH.

REV 10/04

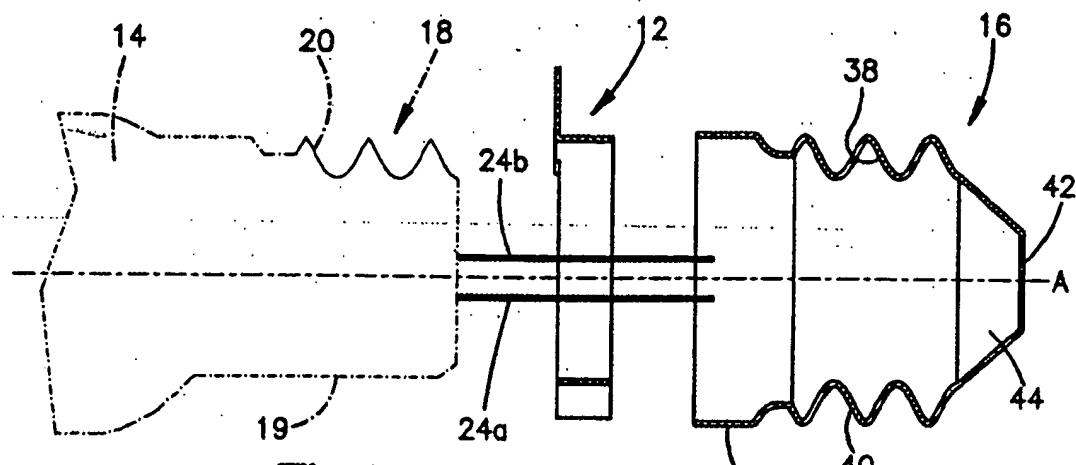


Fig.6

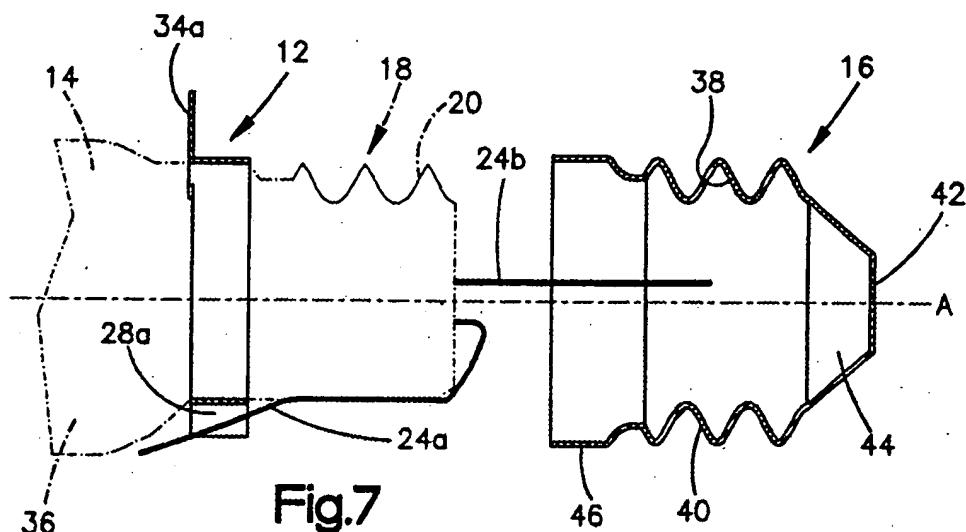


Fig.7

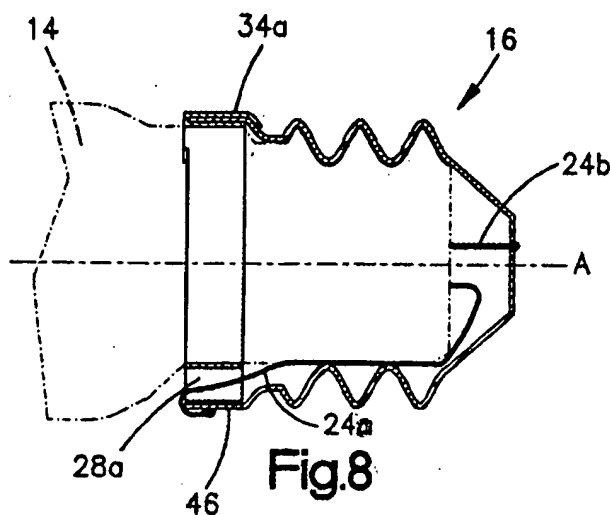


Fig.8